

Date: Wednesday, 5/10/2006 9:18:35 AM  
 User: Kim Johnston

## Process Sheet

Customer : CU-DAR001 Dart Helicopters Services	Drawing Name : 350/212/130 BASKET LID
Job Number : 27048B	
Estimate Number : 10193	
P.O. Number : N/A	Part Number : D2512
This Issue : 5/10/2006 S.O. No. : N/A	Drawing Number : D2512 REV D2
Prsht Rev. : NC	Project Number : N/A
First Issue : N/A Type : LARGE FAB ASSY	Drawing Revision : D2
Previous Run : 27047B	Material : N/A
Written By : <u>SEE COMMENT BELOW</u>	Due Date : 5/30/2006 Qty: 1 Um: Each
Checked & Approved By : <u>06.05.10 N</u>	
Comment : Rev Est: N 03.01.31 Added D2012-117 for D130-701-041 KJ/ RF Est Rev: N 06.04.05 Added level21 EC	

## Additional Product

Job Number:



Seq. #:	Machine Or Operation:	Description :
---------	-----------------------	---------------

1.0	M304TS0750W065	304 SQ Tube.75x.75x.065W
-----	----------------	--------------------------



Comment: Qty.: 45.7594 f(s)/Unit Total : 45.7594 f(s)

Pick:

3/4"x3/4" 304/316 SS tube .063" wall

Batch: M100748 → 282.49"CPL 06.05.17

2.0	D31663	Basket Hoop
-----	--------	-------------



Comment: Qty.: 1.0000 Each(s)/Unit Total : 1.0000 Each(s)

Pick:

Qty Part Number Description

1 D3166-3 Basket Hoop

Batch

B25896CPL 06.05.17

3.0	D2506	Placard
-----	-------	---------



Comment: Qty.: 1.0000 Each(s)/Unit Total : 1.0000 Each(s)

Pick:

Qty Part Number Description

1 D2506 Label Plate

Batch

B26631CPL 06.05.23

4.0	D23271	Spacer Bushing
-----	--------	----------------



Comment: Qty.: 2.0000 Each(s)/Unit Total : 2.0000 Each(s)

Pick:

Qty Part Number Description

2 D2327-1 Bushing

Batch

B26742CPL 06.05.23

W/O:		WORK ORDER CHANGES					
DATE	STEP	PROCEDURE CHANGE	By	Date	Qty	Approval Mfg / Design Mgr	Approval QC Inspector

NCR:		WORK ORDER NON-CONFORMANCE (NCR)						
DATE	STEP	Description of NC Section A	Corrective Action Section B			Verification Section C	Approval Design Mgr	Approval QC Inspector
			Initial Design Mgr	Action Description Design Mgr	Sign & Date			

Part No: \_\_\_\_\_ PAR #: \_\_\_\_\_ Fault Category: \_\_\_\_\_ NCR: Yes No DQA: \_\_\_\_\_ Date: \_\_\_\_\_

NOTE: Date & initial all entries

QA: N/C Closed: \_\_\_\_\_ Date: \_\_\_\_\_

Date: Wednesday, 5/10/2006 9:18:36 AM  
User: Kim Johnston

## Process Sheet

Customer: CU-DAR001 Dart Helicopters Services

Drawing Name: 350/212/130 BASKET LID

Job Number: 27048B

Part Number: D2512

Job Number:



Seq. #:

Machine Or Operation:

Description :

5.0

D22321

Hinge



Comment: Qty.: 2.0000 Each(s)/Unit Total : 2.0000 Each(s)

Pick:

Qty Part Number Description

2 D2232-1 Hinge plate

Batch

32523B

CPL 06-05-18

6.0

D2581

Mounting Bracket



Comment: Qty.: 2.0000 Each(s)/Unit Total : 2.0000 Each(s)

Pick:

Qty Part Number Description

2 D2581 Mounting Bracket

Batch

326204

CPL 06-05-18

7.0

M304EX07516F

Expanded Metal Flat Stai



Comment: Qty.: 18.0000 sf(s)/Unit Total : 18.0000 sf(s)

Pick:

Qty Part Number Description

18 sf M304EX0.75-16F Expanded Metal

Batch

M100981

CPL 06-05-23

8.0

LARGE FAB 1

LARGE FABRICATION RESOURCE 1



Comment: LARGE FABRICATION RESOURCE 1

1-Cut 3/4" x 3/4" square tubing as per Dwg D2512

2-Cut (4) D2236 From D3166-3

3-Drill holes in D2512-1 as per Dwg D2512 using Drill Jig DT8305

4-D2012-117 is included in D3172-041 EC130 Basket Base BOM.  
EC130 Basket only

Pick:

Qty Part Number Description

2 D2012-117 Clevis

Batch

5-Weld as per Dwg D2512 using Welding Table and corner Jig Deburr as required

CPL 06-05-29

*[Signature]*  
06-06-09

W/O:		WORK ORDER CHANGES					
DATE	STEP	PROCEDURE CHANGE	By	Date	Qty	Approval Mfg / Design Mgr	Approval QC Inspector

NCR:		WORK ORDER NON-CONFORMANCE (NCR)						
DATE	STEP	Description of NC Section A	Corrective Action Section B			Verification Section C	Approval Design Mgr	Approval QC Inspector
			Initial Design Mgr	Action Description Design Mgr	Sign & Date			

Part No: \_\_\_\_\_ PAR #: \_\_\_\_\_ Fault Category: \_\_\_\_\_ NCR: Yes No DQA: \_\_\_\_\_ Date: \_\_\_\_\_

NOTE: Date & initial all entries

QA: N/C Closed: \_\_\_\_\_ Date: \_\_\_\_\_

Date: Wednesday, 5/10/2006 9:18:36 AM  
User: Kim Johnston

## Process Sheet

Customer: CU-DAR001 Dart Helicopters Services

Drawing Name: 350/212/130 BASKET LID

Job Number: 27048B

Part Number: D2512

Job Number:



Seq. #:

Machine Or Operation:

Description :

9.0

QC9/6

DDIMENSIONAL & WELDING INSPECTION



Comment: DDIMENSIONAL & WELDING INSPECTION

PD

06-05-29

①

10.0

POWDER COATING

POWDER COATING



Comment: POWDER COATING

Powder Coat White Gloss (Ref: 4.3.5.1) as per QSI 005 4.3

06-06-08 ①

11.0

HAND FINISHING1

HAND FINISHING RESOURCE #1



Comment: HAND FINISHING RESOURCE #1

Wing Walk and Spray Paint black as per Dwg D2512 and QSI 005 4.4

Batch:

Wing Walk

Spraying

m100052

m101242

FC 060612

12.0

QC3

INSPECT POWDER COAT/CHEMICAL CONVERSION



Comment: INSPECT POWDER COAT/CHEMICAL CONVERSION

06/06/15 ① PTO

13.0

PACKAGING 1

PACKAGING RESOURCE #1



Comment: PACKAGING RESOURCE #1

Identify and Stock

Location:

DA

14.0

DC

DOCUMENT CONTROL



Comment: DOCUMENT CONTROL

Inspection Level 21


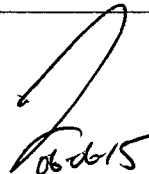

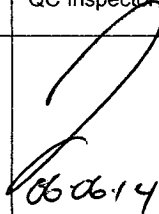
06/06/19 ①


Job Completion



06-06-19

W/O:		WORK ORDER CHANGES					
DATE	STEP	PROCEDURE CHANGE	By	Date	Qty	Approval Mfg / Design Mgr	Approval QC Inspector

NCR:		WORK ORDER NON-CONFORMANCE (NCR)						
DATE	STEP	Description of NC Section A	Corrective Action Section B			Verification Section C	Approval Design Mgr	Approval QC Inspector
			Initial Design Mgr	Action Description Design Mgr	Sign & Date			
060614	10	tiny object found rattling inside of the fuel.		drill hole as necessary to remove object. Fill hole with weld as per QS1004, and grind flush. Repowder coat. AS per RS 1004 QS1005 4.3.5.1	CPL 060616	 060615	 060615	 060614

Part No: \_\_\_\_\_ PAR #: \_\_\_\_\_ Fault Category: \_\_\_\_\_ NCR: Yes ☒ No ☐ DQA:  Date: 06/06/19

NOTE: Date & initial all entries

QA: N/C Closed: \_\_\_\_\_ Date: \_\_\_\_\_




DESIGN BW	DRAWN BY UP	DART AEROSPACE LTD HAWKESBURY, ONTARIO, CANADA	
CHECKED #	APPROVED #	DRAWING NO. D2512	REV. D SHEET 1 OF 4
DATE 01.04.19		TITLE BASKET LID ASSEMBLY (350/212)	
A		95.11.21	NEW ISSUE
B		96.05.24	ADDED LATCH CHANNEL & LABEL PLATE
C		99.07.06	REMOVE DOUBLE SKIN SECTION, ADDED MEMBERS, INCORP. DEO 9074
D		01.04.19	CHANGE HINGE
D1		03.01.20	ADD D2012-117 FOR D130-701-041
D2		04.09.20	TACK WELD ANT-SKID AREA

RELEASED  
01.04.27 #

PARTS LIST FOR D2512 BASKET LID ASSEMBLY

PART NO	QUANTITY	LENGTH A	LENGTH B	DESCRIPTION
D2512-1	2	—	25.50	RIB
D2512-3	2	—	95.30	RIB
D2512-5	6	30.84	—	RIB
D2512-7	3	30.63	—	RIB
D2232-1	2	N/A	N/A	HINGE PLATE
D2236	4	N/A	N/A	RIB
D2327-1	2	N/A	N/A	BUSHING
D2506	1	N/A	N/A	LABEL PLATE
D2581	2	N/A	N/A	MOUNTING BRKT

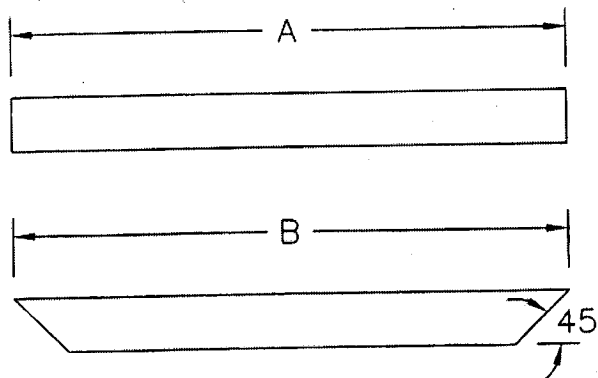

D2512-1/-3/-5/-7

CUT LENGTH/SHAPE PER DIAGRAM AND PARTS LIST

MATERIAL: AISI 304/316 SS, 3/4 X 3/4 X 0.060 WALL SQUARE TUBING

TOLERANCES ARE PER DART QSI 018 UNLESS OTHERWISE NOTED

ALL DIMENSIONS ARE IN INCHES

SHOP COPY  
RETURN TO  
ENGINEERING

UNCONTROLLED COPY

SUBJECT TO AMENDMENT  
WITHOUT NOTICE



WORK ORDER  
NO. 27048 B

Copyright © 1995 by DART AEROSPACE LTD

THIS DOCUMENT IS PRIVATE AND CONFIDENTIAL AND IS SUPPLIED ON THE EXPRESS CONDITION THAT IT IS NOT TO BE USED FOR ANY PURPOSE OR COPIED OR COMMUNICATED TO ANY OTHER PERSON WITHOUT WRITTEN PERMISSION FROM DART AEROSPACE LTD.



DESIGN	BW	DRAWN BY	<i>CP</i>	DART AEROSPACE LTD HAWKESBURY, ONTARIO, CANADA
CHECKED	<i>CP</i>	APPROVED	<i>CP</i>	DRAWING NO. D2512
DATE	01.04.19	TITLE	BASKET LID ASSEMBLY (350/212)	REV. D SHEET 2 OF 4
		SCALE	1:20	

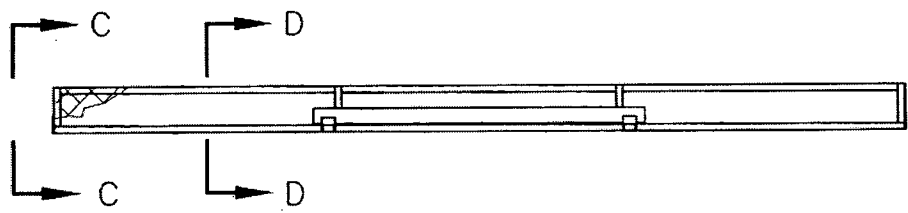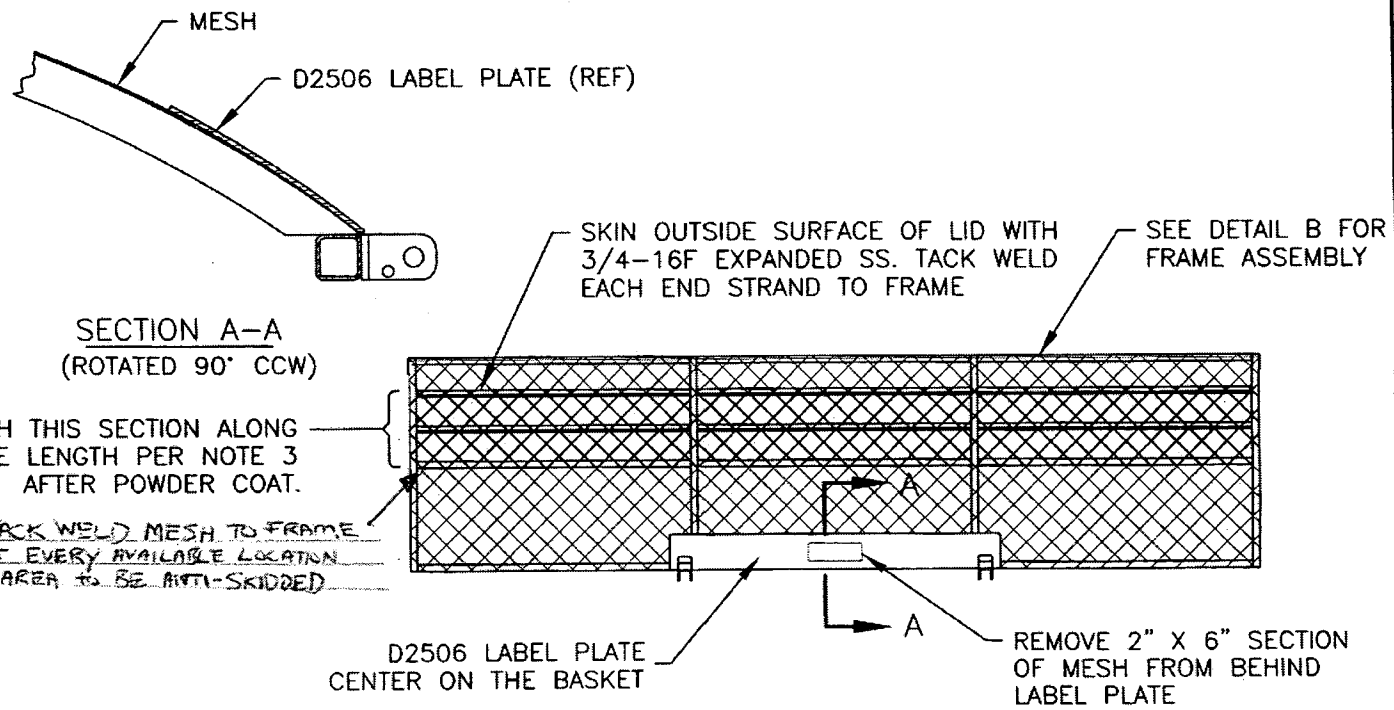

**D2512 BASKET LID ASSEMBLY**

- 1) MESH MATERIAL: 3/4-16F EXPANDED SS
- 2) FINISH: POWDER COAT ENTIRE ASSEMBLY WHITE (4.3.5.2) PER DART QSI 005 4.3
- 3) SPRAY PAINT BLACK INSIDE SURFACE  
APPLY BLACK ANTI-SKID TO OUTSIDE SURFACE PER DART QSI 005 4.4
- 4) TOLERANCES ARE PER DART QSI 018 UNLESS OTHERWISE NOTED
- 5) ALL DIMENSIONS ARE IN INCHES


SHOP COPY  
RETURN TO  
ENGINEERING  
CONTROLLED COPY  
RELEASED  
01.04.19  
WORK ORDER  
NO. 27048B

Copyright © 1985 by DART AEROSPACE LTD  
THIS DOCUMENT IS PRIVATE AND CONFIDENTIAL AND IS SUPPLIED ON THE EXPRESS CONDITION THAT IT IS NOT TO BE USED FOR ANY PURPOSE OR COPIED OR COMMUNICATED TO ANY OTHER PERSON WITHOUT WRITTEN PERMISSION FROM DART AEROSPACE LTD.





DESIGN	DRAWN BY	DART AEROSPACE LTD
BW	MP	HAWKESBURY, ONTARIO, CANADA
CHECKED	APPROVED	DRAWING NO.
DATE		D2512
01.04.19		SHEET 3 OF 4
		SCALE
		1:20
		TITLE
		BASKET LID ASSEMBLY (350/212)

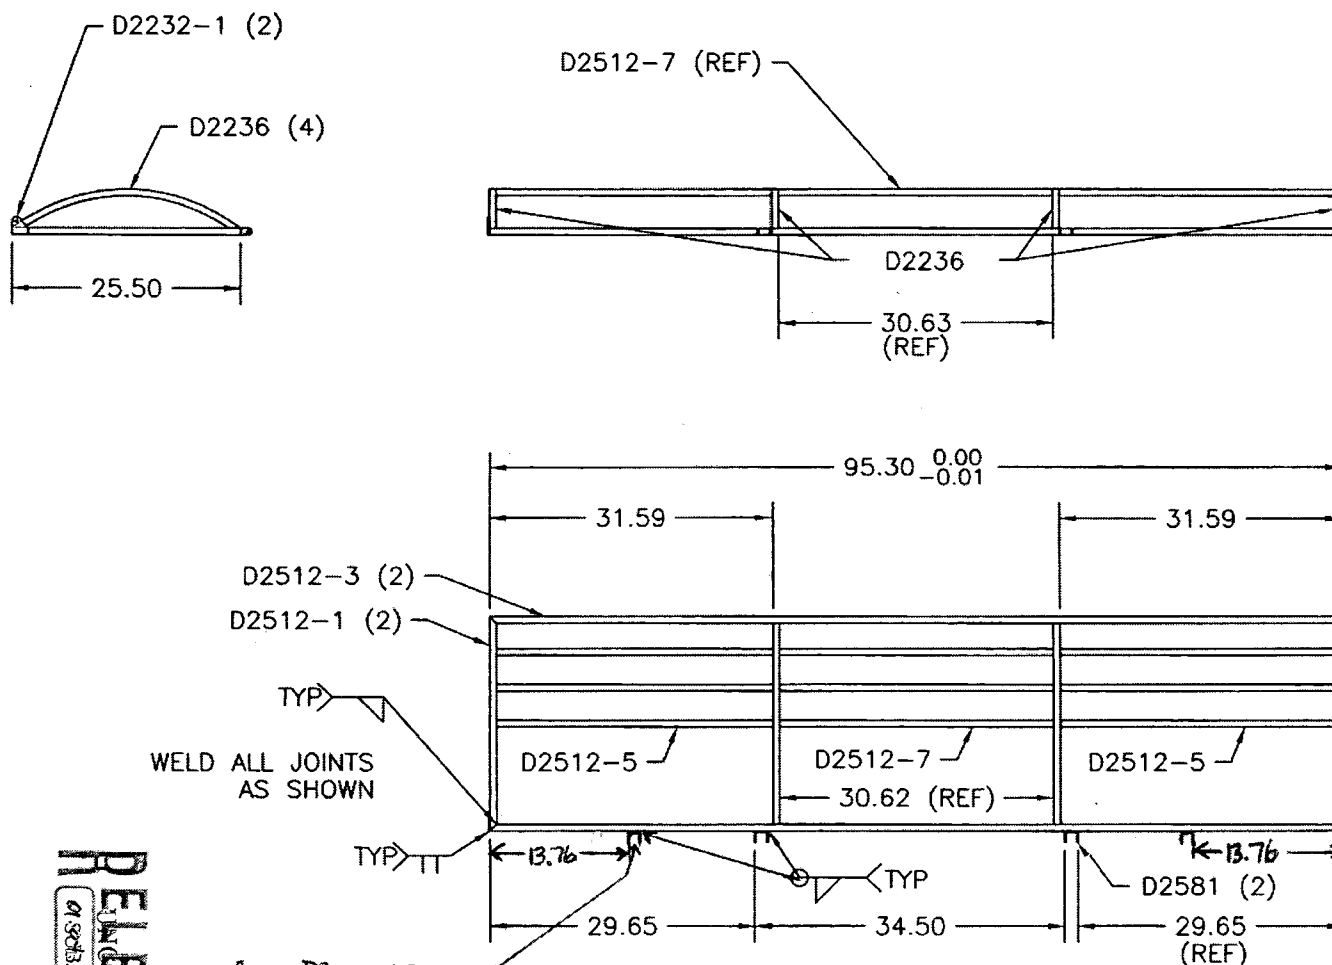


DETAIL B  
FRAMEWORK SHOWN FOR CLARITY  
TOLERANCES ARE PER DART QSI 018 UNLESS OTHERWISE NOTED  
ALL DIMENSIONS ARE IN INCHES


RELEASED  
ENGINEERING  
COPY  
SUBJECT TO AMENDMENT  
WITHOUT NOTICE  
WORK ORDER  
NO. 21048B




DESIGN BW	DRAWN BY UP	DART AEROSPACE LTD HAWKESBURY, ONTARIO, CANADA	
CHECKED #	APPROVED #	DRAWING NO. D2512	REV. D SHEET 4 OF 4
DATE 01.04.19		TITLE BASKET LID ASSEMBLY (350/212)	SCALE 1:8

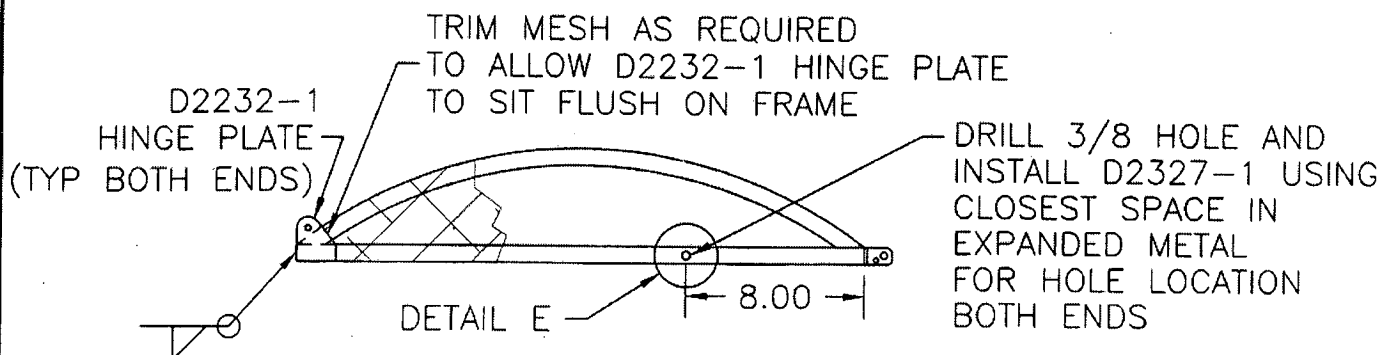

SECTION C-C SIMILIAR BOTH END RIBS

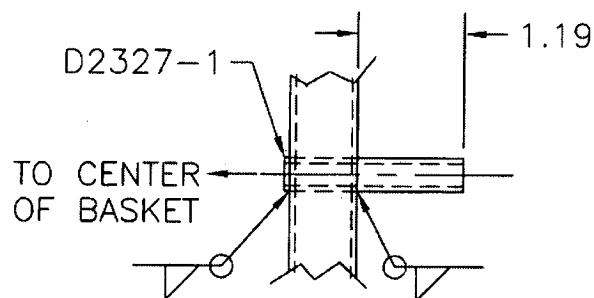

DETAIL E

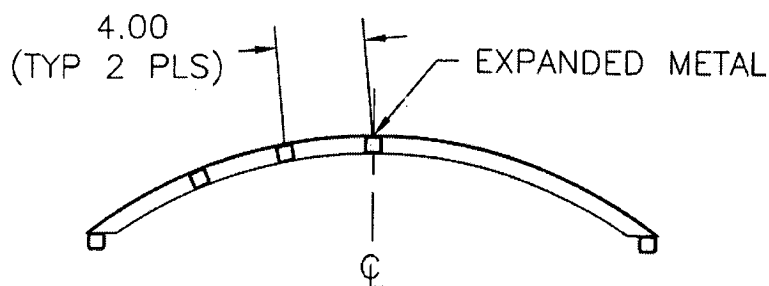

SECTION D-D SAME BOTH CENTER RIBS

SHOP COPY

RETURN TO

ENGINEERING

UNCONTROLLED COPY

SUBJECT TO AMENDMENT

WITHOUT NOTICE

WORK ORDER

NO. 27048B

Copyright © 1995 by DART AEROSPACE LTD

THIS DOCUMENT IS PRIVATE AND CONFIDENTIAL AND IS SUPPLIED ON THE EXPRESS CONDITION THAT IT IS NOT TO BE USED FOR ANY PURPOSE OR COPIED OR COMMUNICATED TO ANY OTHER PERSON WITHOUT WRITTEN PERMISSION FROM DART AEROSPACE LTD.